


Ground Floor

Working copy, any discrepancies are to be reported to a signed release

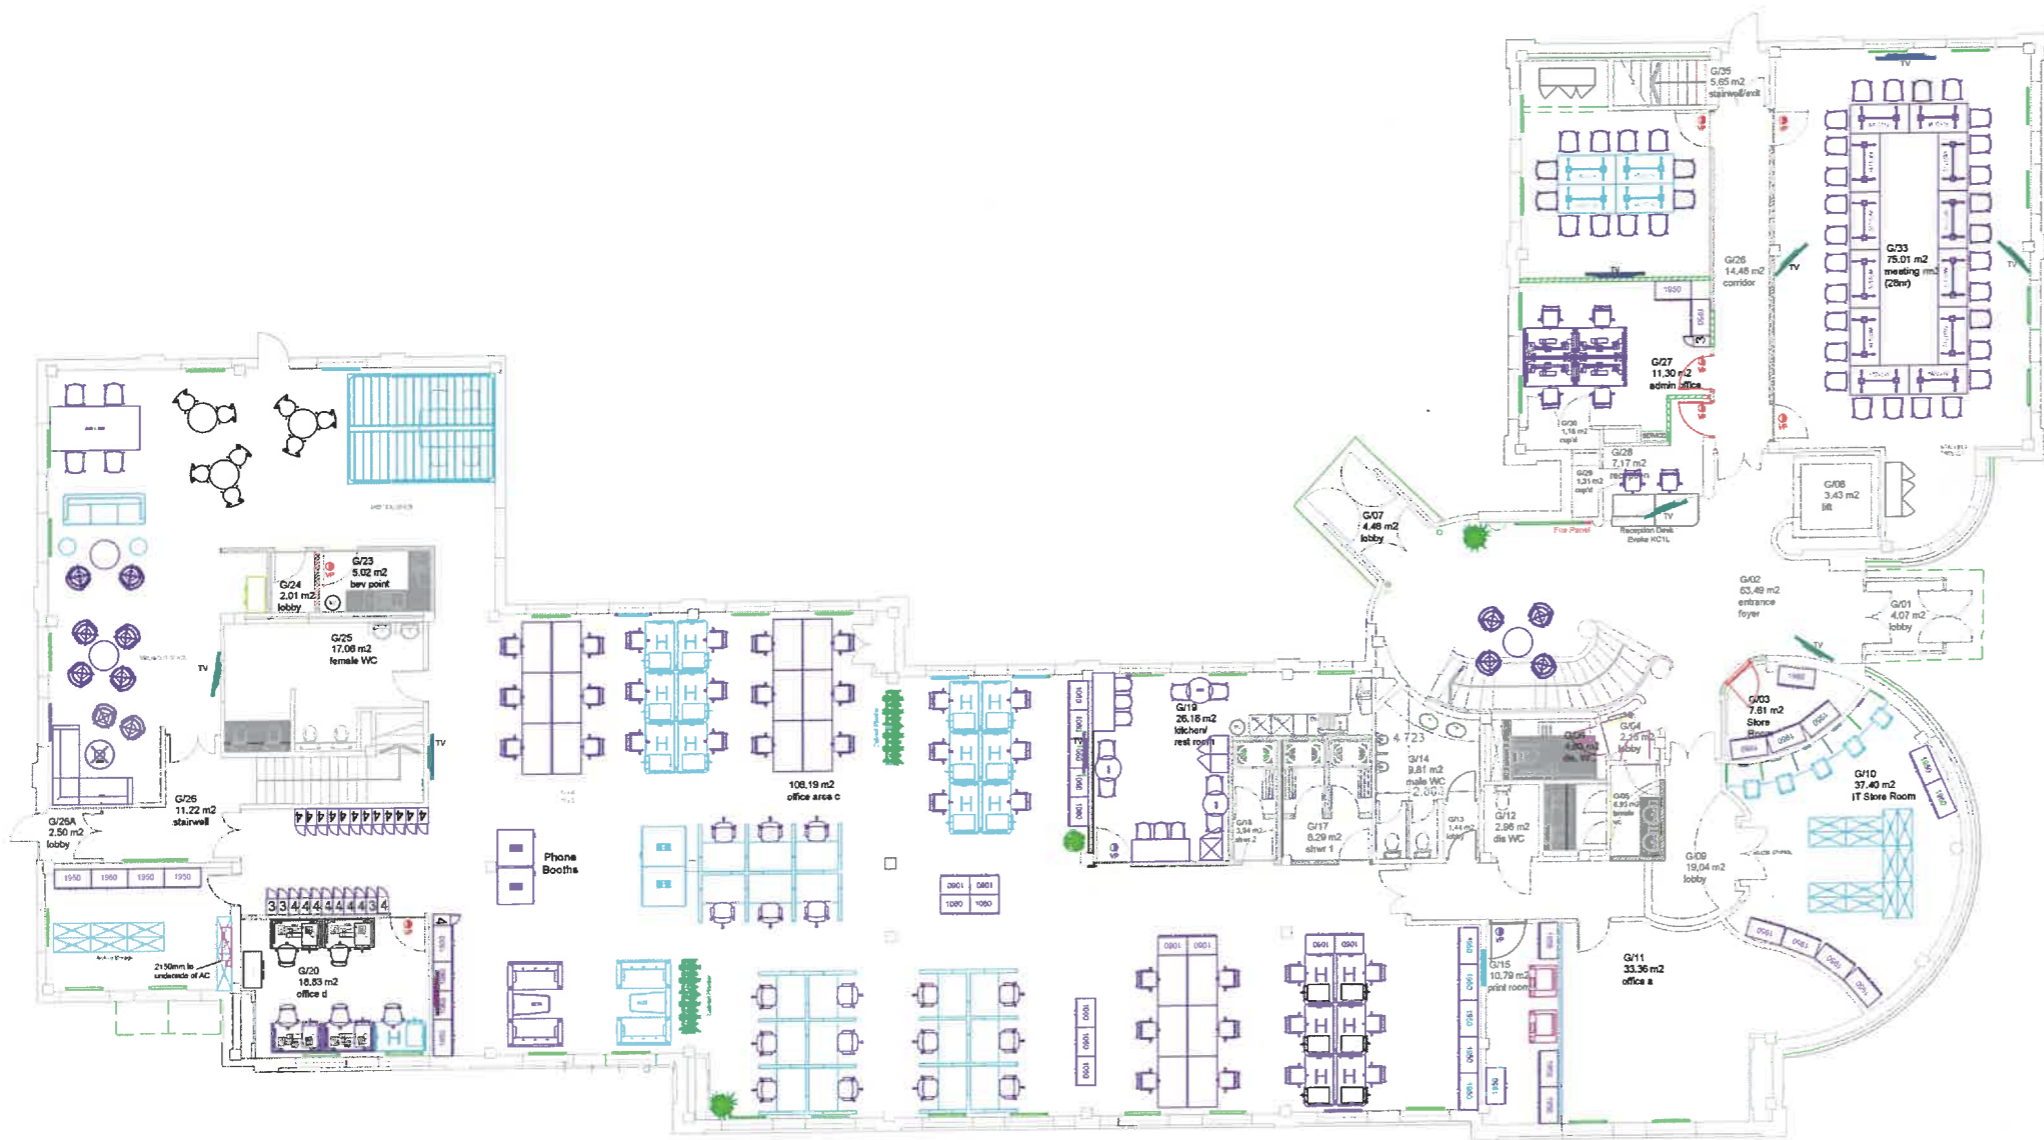

Rev	Description	Date	Name
I	As Built Layout	03-22	RB
H	Revised reception office partition layout, move kitchen to end of TV and door into female WC, show seating TV which used to be removed	19-1-22	RB
O	Revised reception door location	19-4-21	RB
F	Adjusted storage and locker sizes, four more new lockers	13-1-21	RB
E	Desk counts	09-11-21	MS
D	Product images added	18/10/21	MS
C	Amendments made as per Madine comments	13-10-21	EM
B	Included the new reception desk	04/10/21	EM
A	Changes made as per client comments	24/08/21	EM



Site Address:
 Wicker House
 High St
 Worthing
 BN11 1DJ

Client:
 NHS

Project Title:
 Wicker House

Drawing Title:
 GROUND FLOOR


Drawing Scale: 1:100@A1
Issue Date: 22/07/2021

Drawn by: EM / MS
Revision: I


Drawing Number:
 WG 21061-00-04

Drawing Issue Status:
 AS BUILT LAYOUT

Wipacstaff Group
 5 Bromham Way, Chislehurst,
 London, EC1V 4AB, T: 0204 632 3900
 E: marketing@wipacstaffgroup.co.uk
 W: www.wipacstaffgroup.co.uk

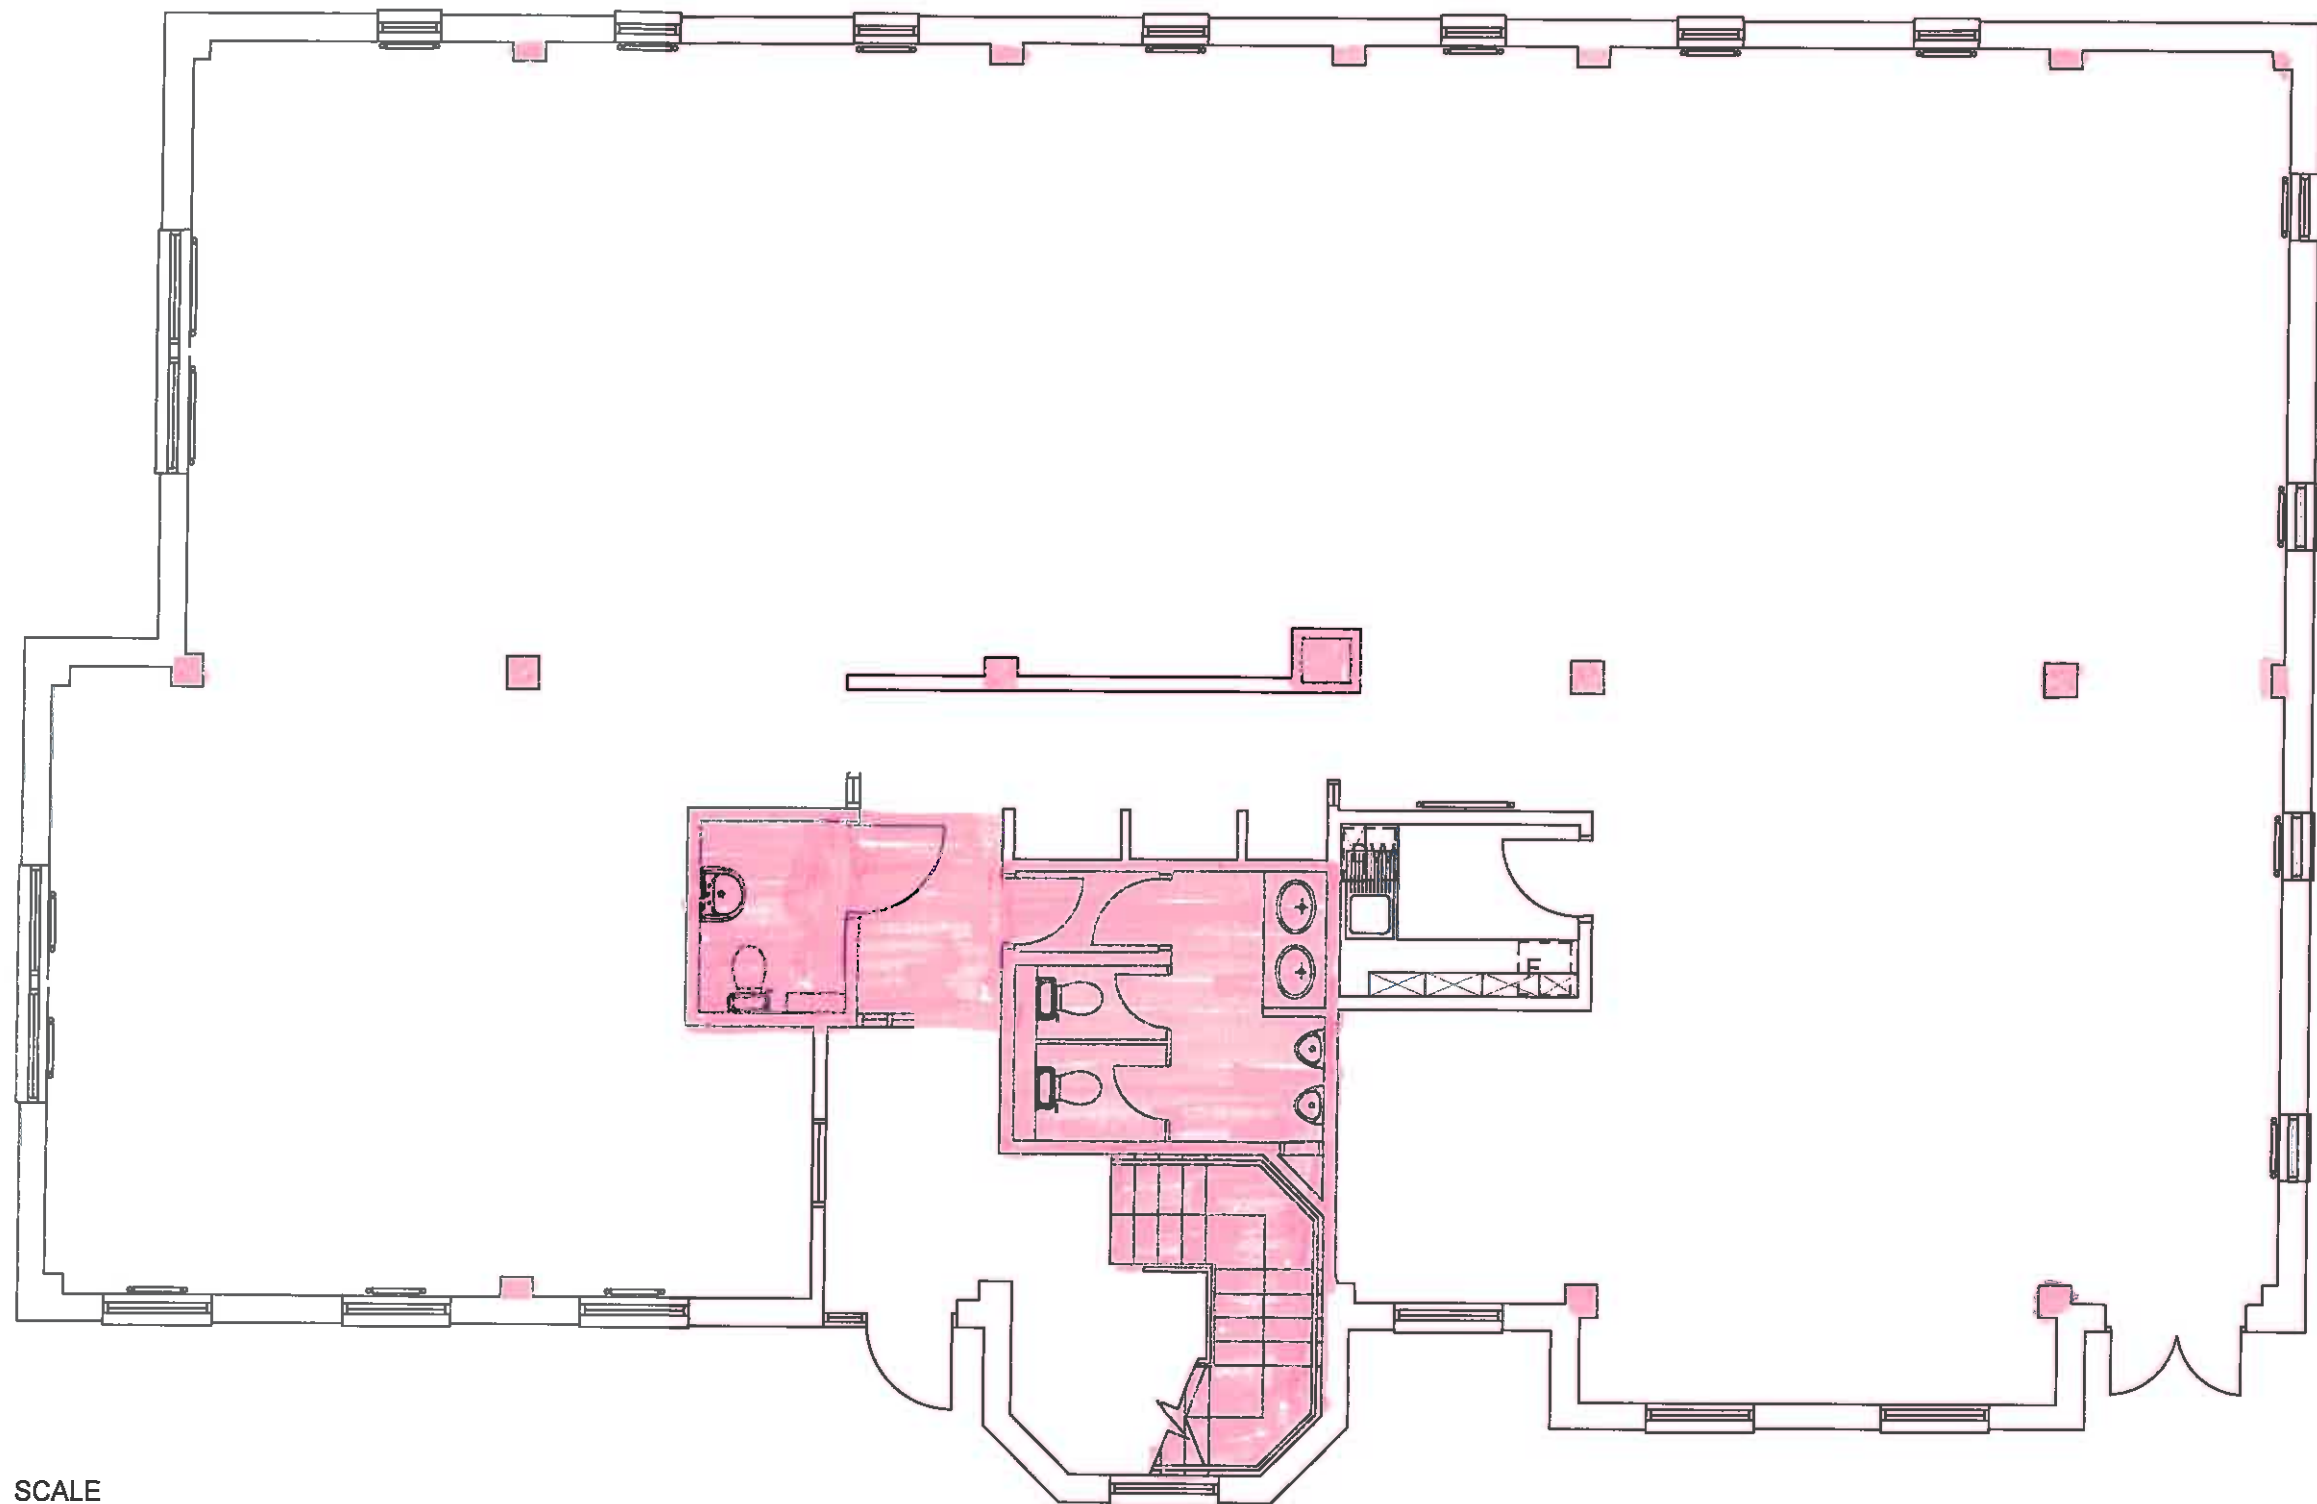


SCALE

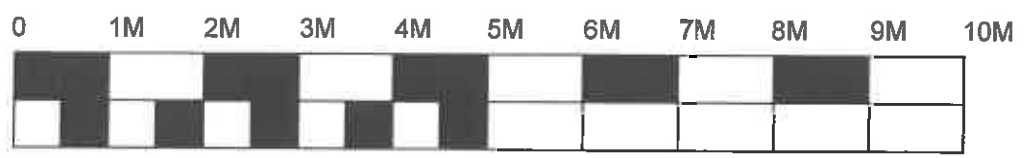


500mm

EAGLE HOUSE GROUND FLOOR

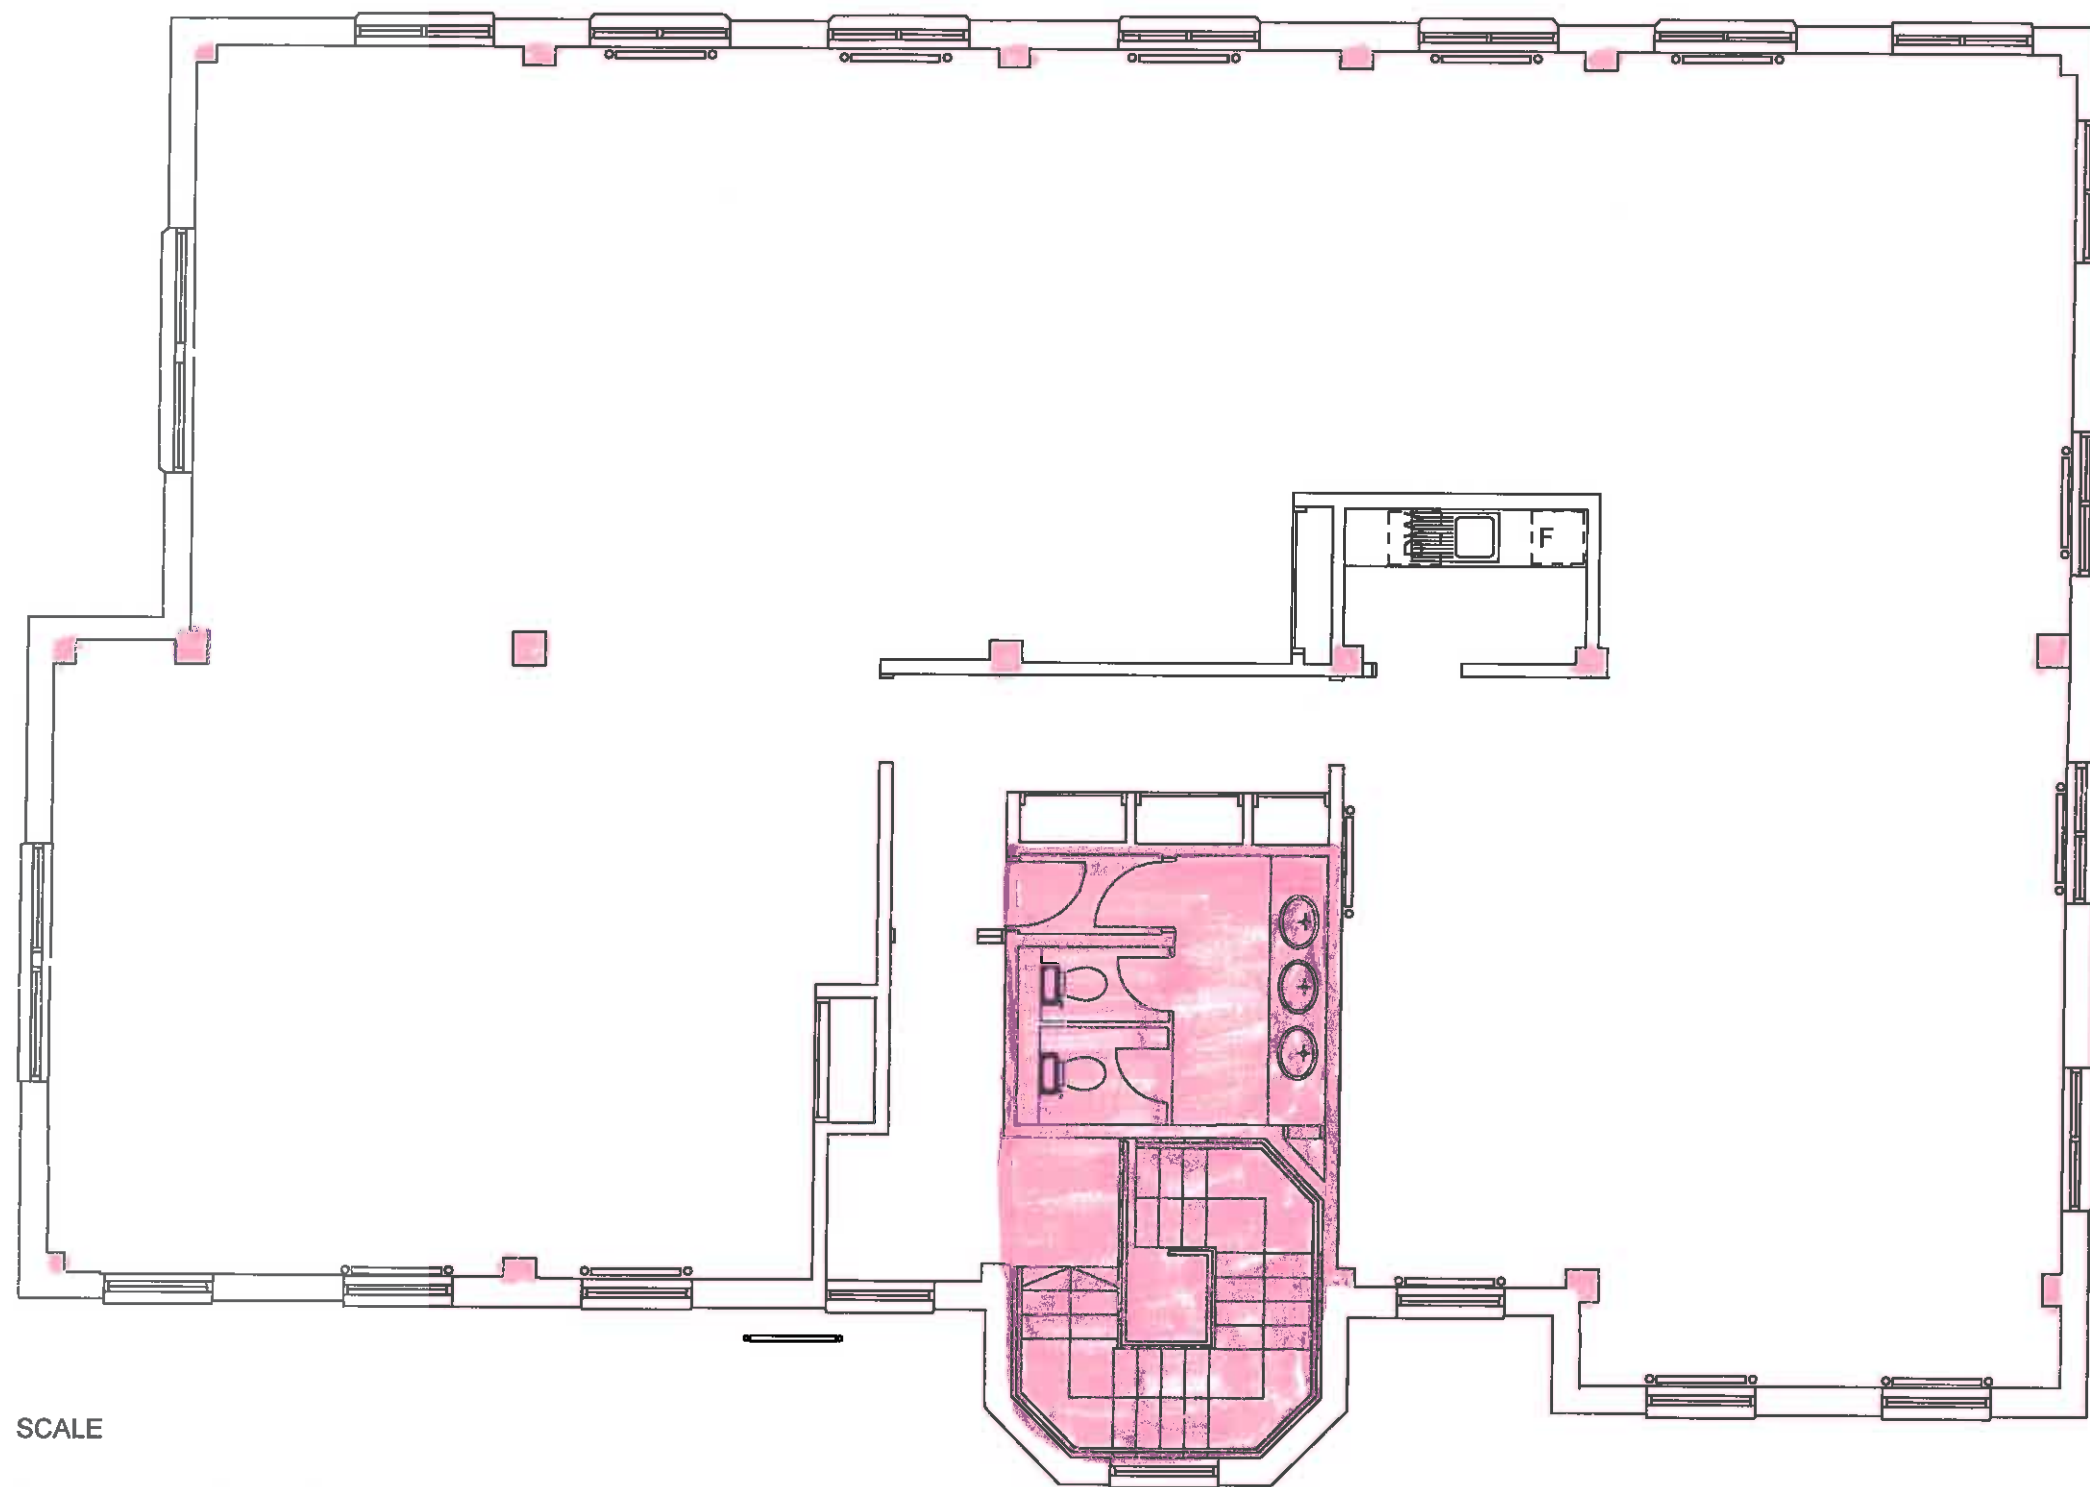

SCALE

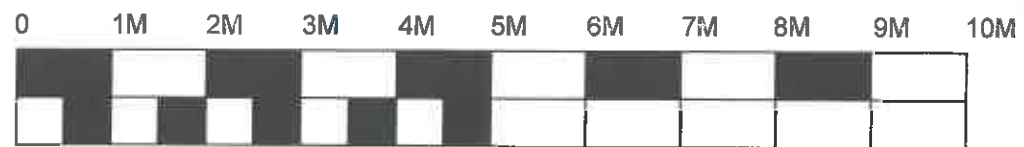


500mm

EAGLE HOUSE FIRST FLOOR

First Floor

COPYRIGHT
 © copyright this drawing shall not be copied or
 whole or in part) without the written consent of Wogstaff Interiors
SCALE
 Dimensions should be noted with care
 contractors must verify all dimensions before
 starting work, any discrepancies are to be
 reported to Wogstaff Interiors

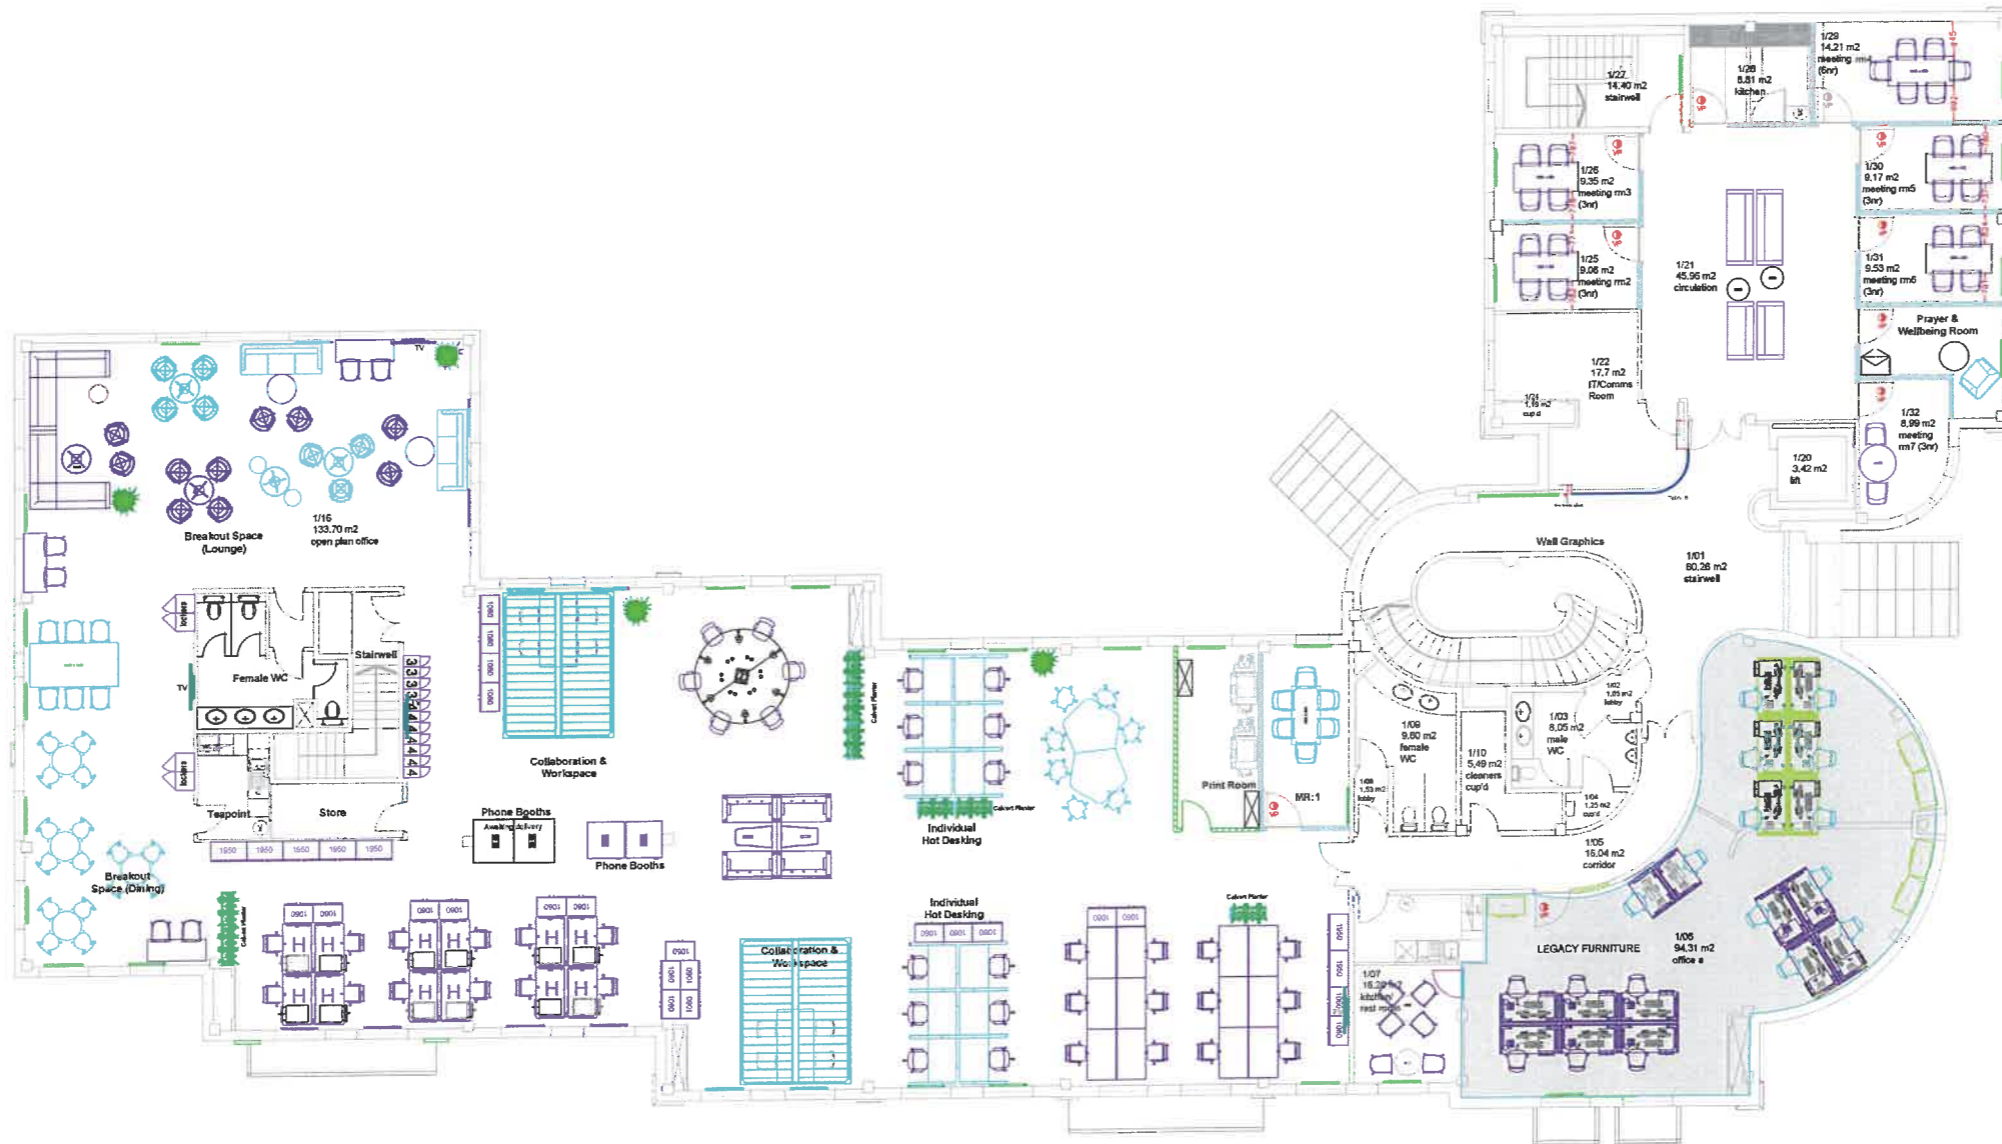

G	As Built Layout	9-3-22	RS
F	Recreate feature wall to new store room wall	18-1-22	RS
E	Desk count	06/11/21	MS
D	Product images added	18/10/21	EM
C	Amendments made as per Maura comments	15/10/21	EM
B	Included the new reception desk	04/10/21	EM
A	Changes made as per client comments	24/09/21	EM



Site Address:
 Wicker House
 High St
 Worthing
 BN11 1DU

Client:
 NHS

Project Title:
 Wicker House

Drawing Title:
 FIRST FLOOR
 Post Covid Layout

Drawing Scale: 1:100@A1
 Issue Date: 22/07/2021

Drawn by: EM / MS
 Revision: 0

Drawing Number:
 WG 21061-01-04

Drawing Issue Status:
AS BUILT LAYOUT

Wogstaff Interiors Group
 9 Brothers Yard, Chichester
 London, EC1Y 4AR, Floor 12, 1000
 E: mark.wogstaff@wogstaffgroup.co.uk
 W: www.wogstaffgroup.co.uk